


9/4/2012 Amended PV Areas

The parking lot areas within the red lines to the right and below may be used to propose solar PV systems. The acreage estimates do not apply to these red line areas.

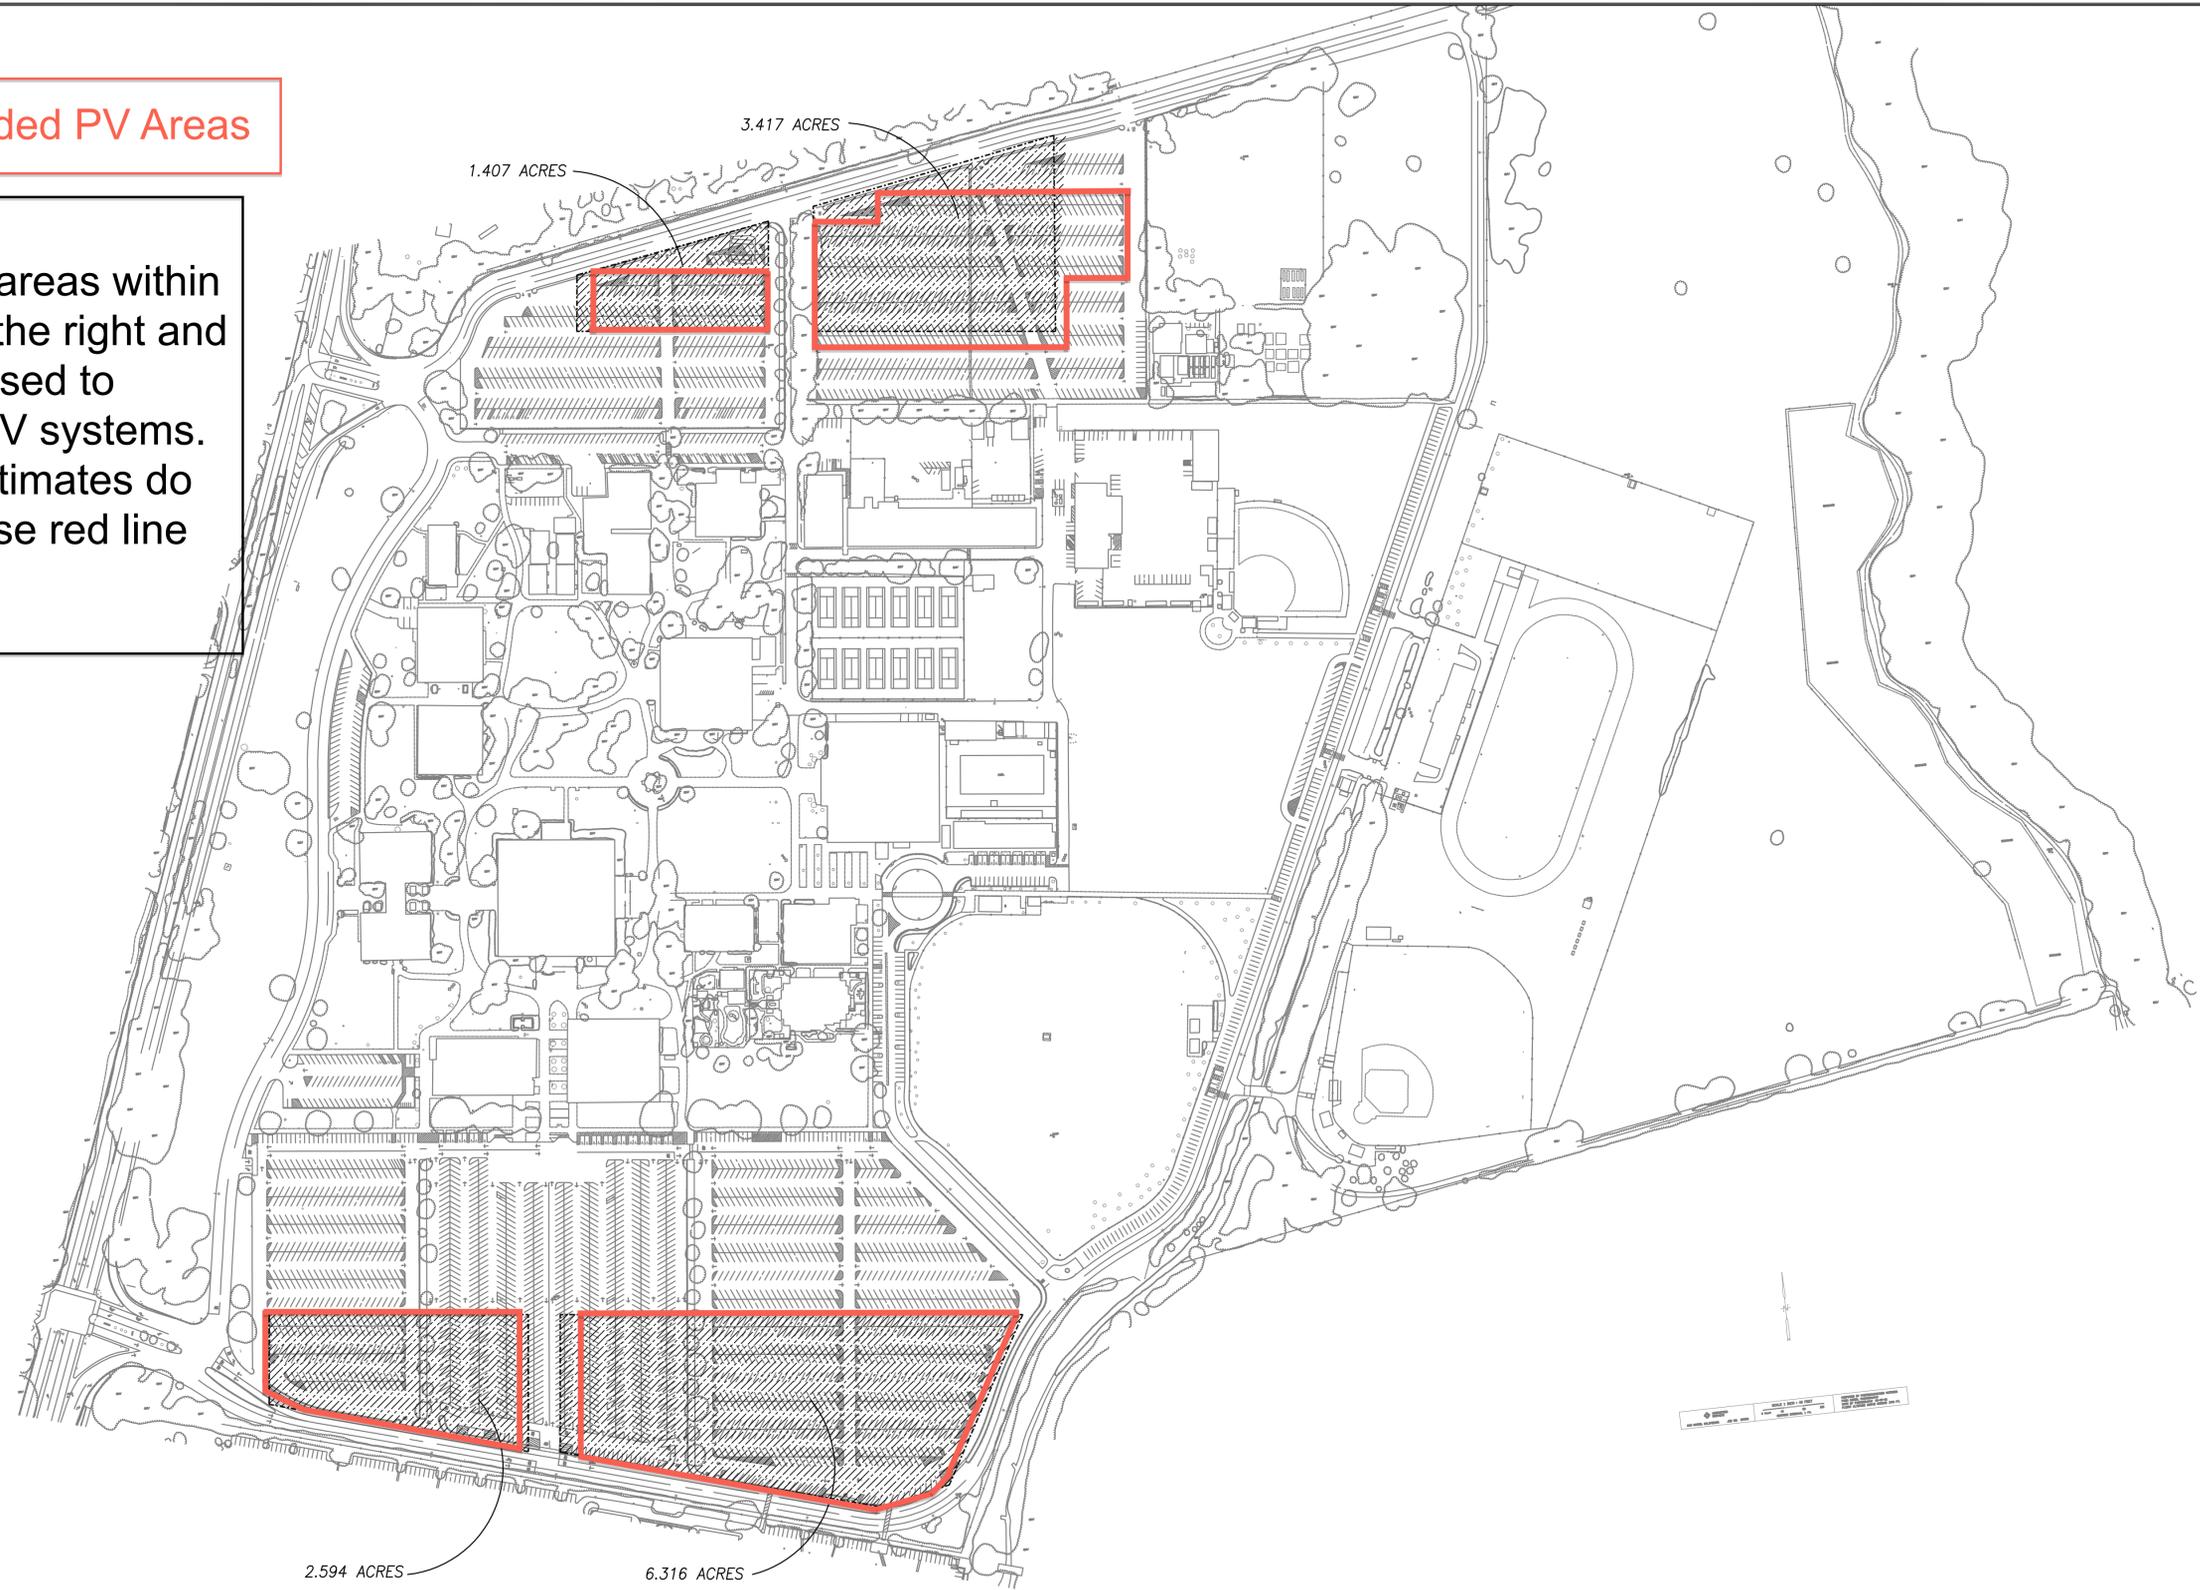

REV	DATE	DESCRIPTION

CONSULTANT

VBN ARCHITECTS
 560 14TH. ST. OAKLAND, CA 94612
 T 510.763.1313 ; www.vbnarch.com

DRAWN	XX
CHECKED	XX
IN CHARGE	XX
DATE	07/17/12

SOLANO COMMUNITY COLLEGE DISTRICT
 SOLANO COMMUNITY COLLEGE- FAIRFIELD CAMPUS
 FACILITIES MASTER PLAN
 SITE PLAN

JOB NUMBER	11023
DRAWING NUMBER	